


(P)

6-5-40.  
B.7549/39.

BASED ON  
SIMMS MOTOR UNITS LTD DRAWING  
No F - 50563.

AIR MINISTRY A.G.S. No. 1635.

SHEET No. 1 No. of SHEETS 1

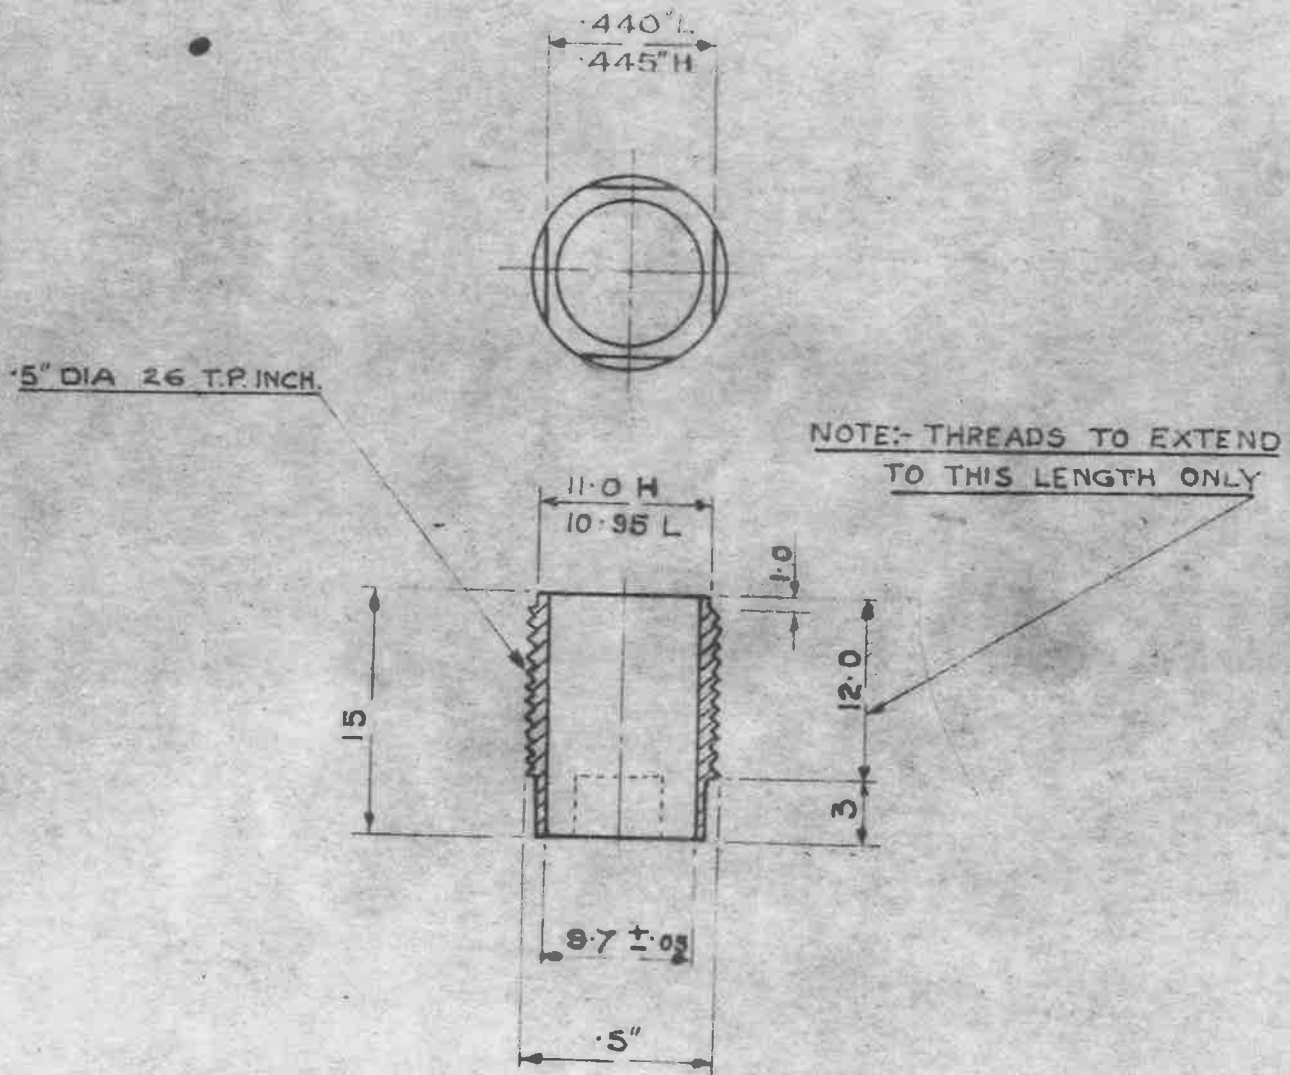

SCREW THREADS TO BE ~~WHITWORTH FORMATION & WITHIN~~  
~~THE LIMITS OF GRADE & PLAY AS SPECIFIED FOR STANDARD~~  
~~FITS FOR A GIVEN PITCH OF THREAD IN B.S. SPECN No 84.-1940~~  
 MEDIUM FIT TABLE 24 TRUNCATED THREADS TABLE 27

MATERIAL :- BRASS ~~B.B. OR B.S. SPEC. 251~~ OR 249

FINISH :- ~~BOILED OIL PLATED~~ ELECTRO-TINNED THICKNESS. NOT LESS THAN .0002"

DIMENSIONS ARE IN 'M/M'S UNLESS OTHERWISE STATED

UNLIMITED DIMENSIONS ±.01"

REF No 5K/2198

SCALE =  $\frac{2}{1}$

ISSUED BY DRAWING OFFICE DIRECTORATE OF TECHNICAL DEVELOPMENT AIR MINISTRY	TITLE— NUT, UNION FOR L.T. CABLE.			RETRACED FOR A B C <i>60X</i>	DRAWN C J Parkis	TRACED GLW 27-4-39
	ISSUE No.	2	3		CHECKED TRACING A R 20/12/41	APPROVED
	ALTERATION	AGS / 380	AS No / AGS/334	AS No / AGS/306		